


G *f* *F* *e* *E* *d* *D* *c* *C* *b* ³¹⁸ *T* 35 *B* *a* *A*

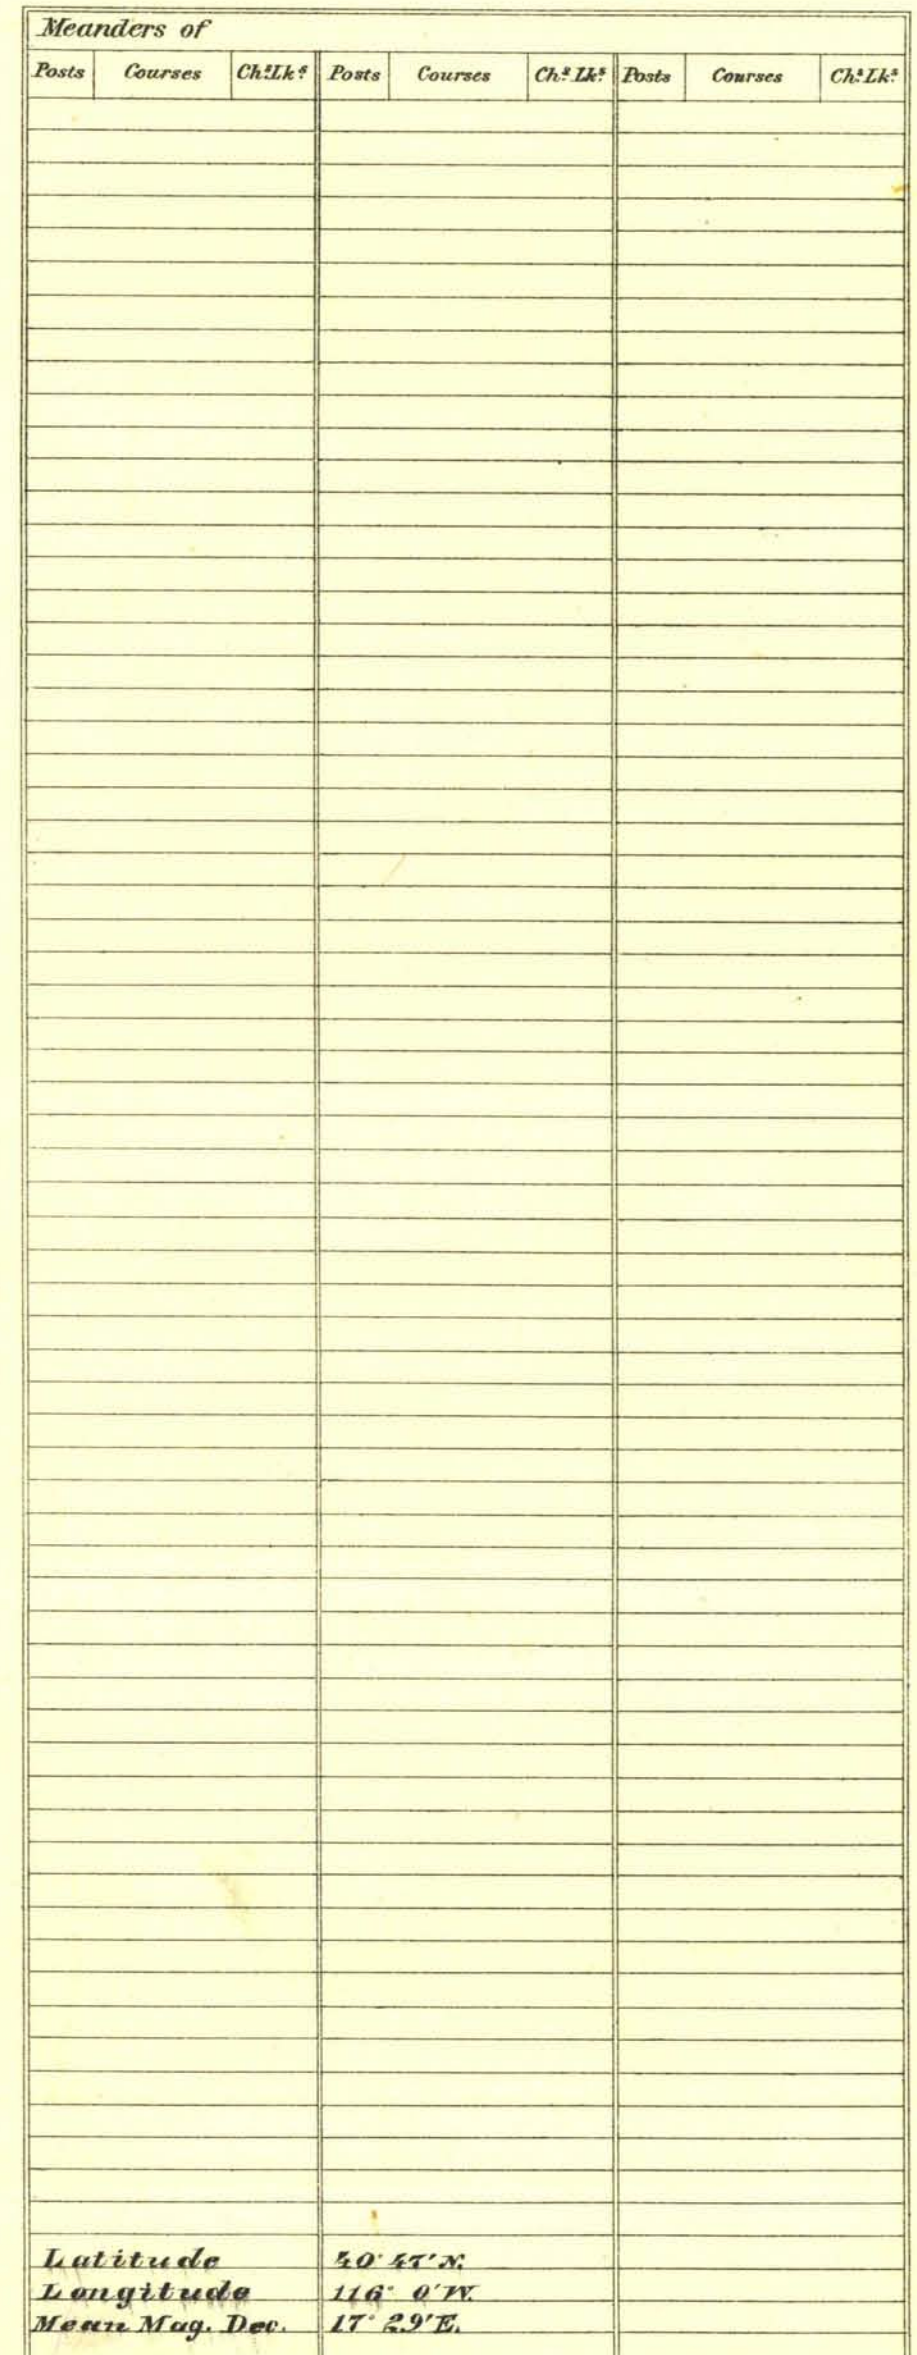

<i>Surveys Designated</i>	<i>By Whom Surveyed</i>	<i>Date of Contract</i>	<i>Amount of Surveys</i> <i>M. Ch. Dc.</i>	<i>When Surveyed</i>	<i>Contract No.</i>
<i>Black Lines</i>	<i>H.B. Maxson</i>	<i>Feb 17 1896</i>		<i>1896</i>	<i>210</i>
<i>Red Lines</i>	<i>Green & Gignoux</i>	<i>Apr 29 1878</i>		<i>1878</i>	<i>79</i>
<i>Green Lines</i>	<i>H.B. Maxson</i>	<i>January 15 1893</i>		<i>1893</i>	<i>199</i>
<i>Yellow Lines</i>	<i>C.C. Tracy</i>	<i>Oct. 22^d 1868</i>		<i>1868</i>	<i>22 21</i>

The above ^{compiled} Map of Township No. 34 N. of Range No. 53 E.
M^t Diablo Meridian, Nevada, is strictly conformable to the field
notes of the survey thereof on file in this Office, which have been examined and approved.
Surveyor General's Office,
Reno, Nevada, Nov. 25 1903
Matthews
Sur. Gen.